

- NOTES:
- LOCATE EQUIPMENT APPROXIMATELY AS SHOWN AT ASSEMBLY.
 - MATCH DRILL FOR APPROPRIATE HARDWARE AT ASSEMBLY AS REQUIRED.
 - WELDING SHALL BE PER MIL-W-22248, CLASS 4.

C&S
COMPANIES

SUBMITTAL
REVIEW

☐ (A) Approved

☒ (A/N) Approved As Noted

☐ (RR) Revise and Resubmit

☐ (REJ) Rejected

☐ (SUB) Submit Specified Item

Checking is only for general compliance with the design concept of the project and general compliance with the information given in the contract documents. Any action shown is subject to the dimensions which shall be confirmed and correlated at the job site; fabrication processes and techniques of construction; coordination of this work with that of all other trades; and the satisfactory performance of his work.

BY **A.CELLA** DATE **2/13/2023**

SUBMITTAL# SPEC

TOWER DEPLOYMENT CONFIGURATIONS

NOTE: DISH RADOME COVER REQ'D FOR ALL CONFIGURATIONS

- TOWER FULLY RETRACTED WITH DISH INSTALLED UP TO 144 MPH WINDS
- TOWER FULLY EXTENDED WITH DISH INSTALLED UP TO 100 MPH WINDS
- TOWER FULLY RETRACTED WITHOUT DISH INSTALLED UP TO 146 MPH WINDS
- TOWER FULLY EXTENDED WITHOUT DISH INSTALLED UP TO 134 MPH WINDS

TOWER EXTENSION & RETRACTION

NOTE: IT IS RECOMMENDED THAT THE TOWER BE LEFT IN THE RETRACTED POSITION WHEN NOT BEING USED

EXTENDING YOUR TOWER:


- YOUR TOWER IS EQUIPPED WITH A WINCH TO ALLOW YOU TO RAISE AND LOWER IT
- CRANK TOWER UP UNTIL IT REACHES DESIRED LEVEL
- THE SAFELY STOP IS SPRING LOADED AND WILL SNAP INTO ITS LOCKED POSITION AT ANY LEVEL WHERE A RUNG IS AVAILABLE ON THE INSIDE SECTION. **WARNING! DO NOT TRY TO TIE-OFF OR DISCONNECT SAFELY STOP IN ANY WAY AS THIS CAN CAUSE SERIOUS INJURY**
- SLIGHTLY LOWER TOWER UNTIL INNER SECTION IS RESTING ON TOP OF THE SAFELY STOP PADDLE
- WHEN THE TOWER IS AT FULL HEIGHT, THE RUNG WITH THE REFLECTIVE ORANGE TAPE SHOULD BE RESTING ON THE SAFELY STOP PADDLES. **NEVER EXCEED THIS HEIGHT OR SERIOUS DAMAGE AND/OR INJURY WILL OCCUR!**

RETRACTING YOUR TOWER:



- TO LOWER YOUR TOWER, PULL DOWN ON SAFETY STOP PULL CORD WITH LIGHT PRESSURE
- SLOWLY CRANK TOWER UP UNTIL SAFETY STOP PADDLE CAN BE DISENGAGED FROM INNER TOWER SECTION **WARNING! DO NOT GO BEYOND THAT POINT TO AVOID JAMMING**
- CONTINUE HOLDING PULL ROPE AND CRANK TOWER DOWN TO ITS FULLY NESTED POSITION

ITEM	QTY.	PART NUMBER	DESCRIPTION	
1	2	806177	BRACKET, BUILDING MOUNT, E SEC, *CUSTOMER SPECIFIC, ASSY	
2	1	806176	RIGGING, T-24XXHD, 2-12FT SECTIONS	NOT SHOWN
3	1	804251	ADAPTER, MAST, COMBO ROTOR PLATE, FOR 2.375" OD, ASSY	
4	1	802658	ASSY, SAFETY STOP, E SECTION, RH SIDE	
5	1	801156	WINCH, WORM GEAR, 1500LBS, ASSY	
6	1	801135	THRUST, BEARING, D SECTION, INCLUDES TOP PLATE AND HARDWARE	
7	1	703886	E SECTION, 12FT L, T-24XXHD	
8	1	703885	D SECTION, 12FT L, T-24XXHD	
9	1	401739	MAST, 2" SCH40 (2.375"OD)X66"L, A-500, GRDB STEEL	


REVISIONS				
REV.	DESCRIPTION	DATE	ENGINEER	ECN
x01	RELEASED FOR DEVELOPMENT	11/14/22	JRR	N/A
A	RELEASED FOR PRODUCTION	12/14/2022	JRR	N/A
B	401739 WAS 400056, 804251 WAS 802123, ADDED NOTES	1/26/2023	JRR	1121

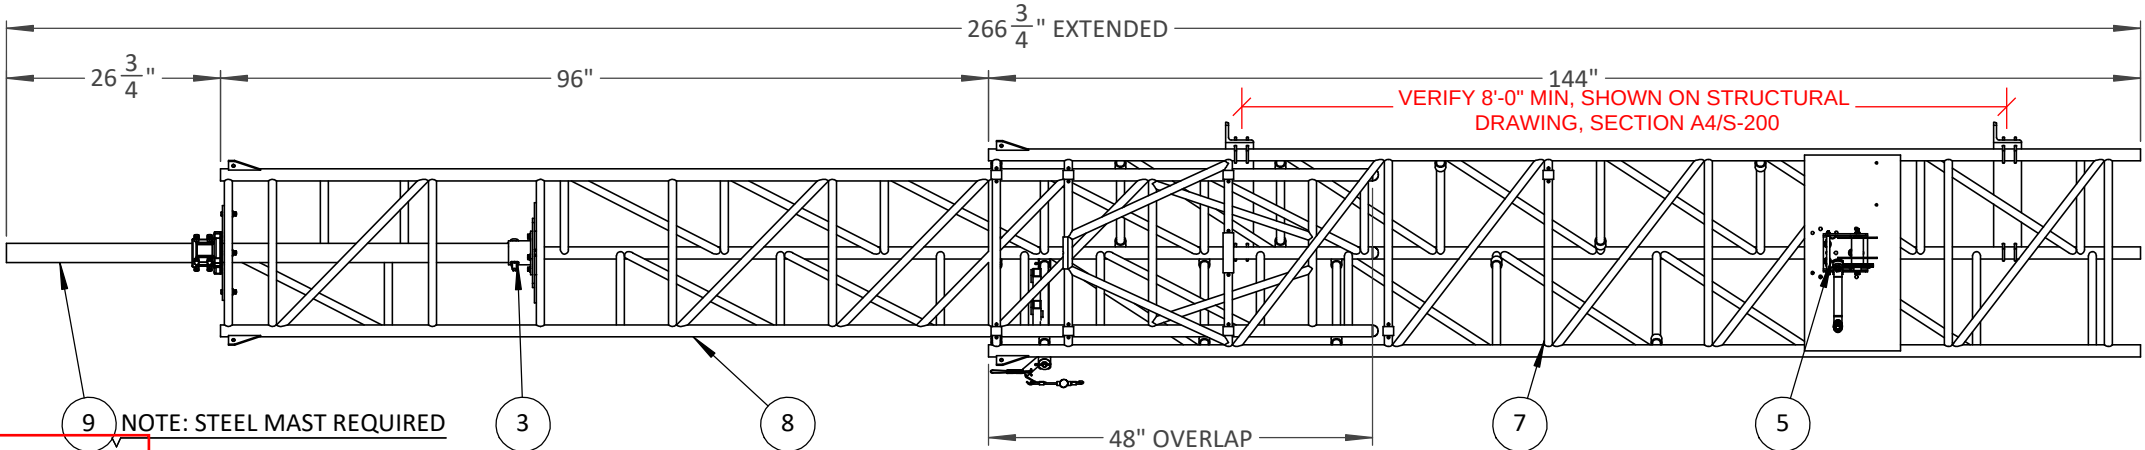

NOTED AS ACCEPTABLE PER UCF
BUILDING DEPT REVIEW

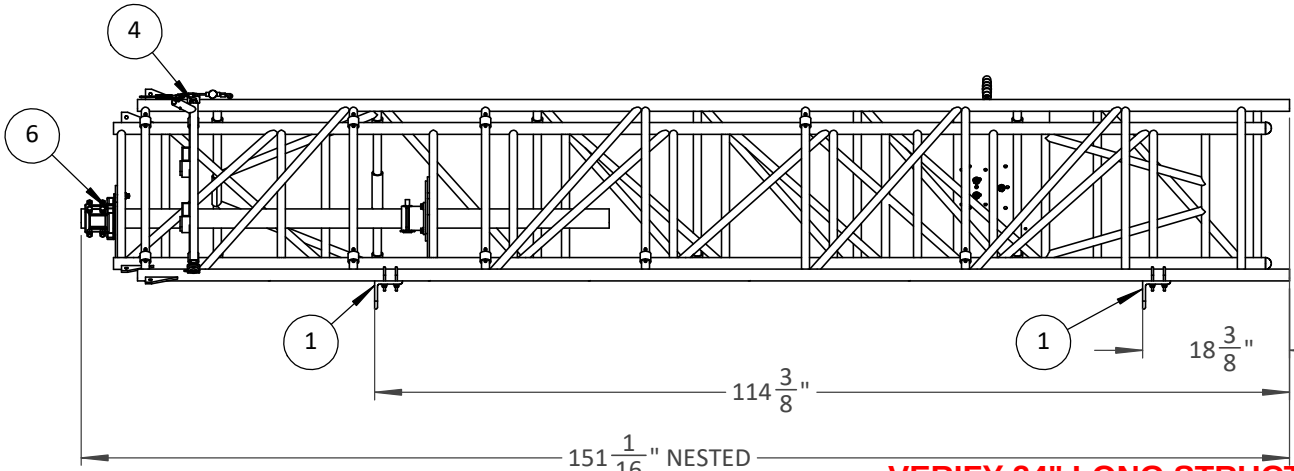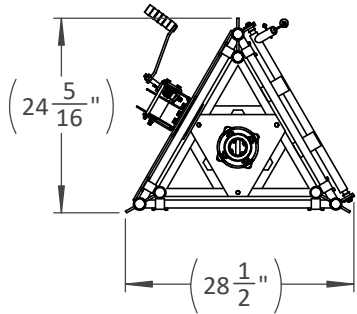



VERIFY 24" LONG STRUCTURAL
STEEL WT4x15.5 IS ADEQUATE
FOR TOWER ATTACHMENT, SEE
DETAIL D2 AND D3 ON S-200

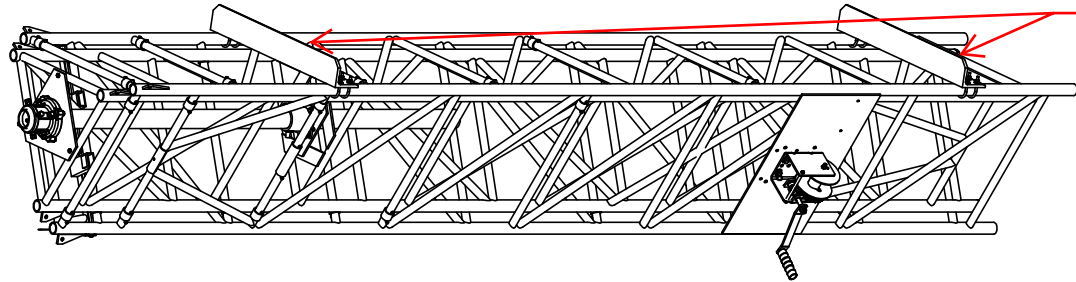


		UNLESS OTHERWISE SPECIFIED	NAME		DATE	 VERO BEACH, FLORIDA 32960 VOICE: 772.567.3423 FAX: 772.567.3432 ALUMATOWER.COM TITLE: TOWER (T-24XXHD), 2-12FT SECT., *CUSTOMER SPECIFIC							
			DRAWN	JRR	11/14/22								
			CHECKED	JVJ	12/14/22								
			ENG APPR.										
			MFG APPR.			SIZE B			DWG. NO. 903768		REV B		
			Q.A.										
			MATERIAL		SEE BOM								
WOA222260		DIMENSIONS ARE IN INCHES. DIMENSIONS WITH  SHALL BE INSPECTED. TOLERANCES: $\frac{X}{Y} \pm \frac{1}{16}$ ANGLE MACH $\pm 1^\circ$ BEND $\pm 5^\circ$ DECIMAL .X ± 0.030 .XX ± 0.010 .XXX ± 0.005   				SCALE: 1:24 WT: 166.885 Lbs SHEET 1 OF 1							
USED ON	NEXT ASSY	REMOVE ALL BURRS AND BREAK EDGES R0.030 OR CHAMFER MAX											
PROPRIETARY AND CONFIDENTIAL													
THE INFORMATION CONTAINED IN THIS DRAWING IS THE SOLE PROPERTY OF ALUMA TOWER COMPANY INC. ANY REPRODUCTION IN PART OR AS A WHOLE WITHOUT THE WRITTEN PERMISSION OF ALUMA TOWER COMPANY INC. IS PROHIBITED. VIOLATORS WILL BE PROSECUTED UNDER APPLICABLE STATE AND FEDERAL LAWS													

NOTES:
1. WELDING SHALL BE PER MIL-W-22248, CLASS 4.


REVISIONS				
REV.	DESCRIPTION	DATE	ENGINEER	ECN
A	RELEASED FOR PRODUCTION	12/14/22	JRR	N/A

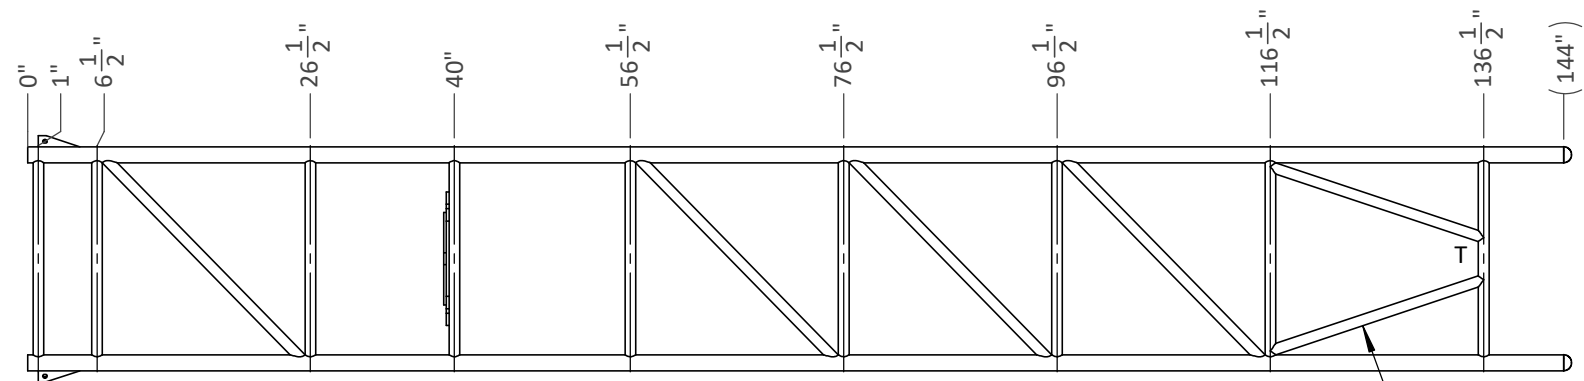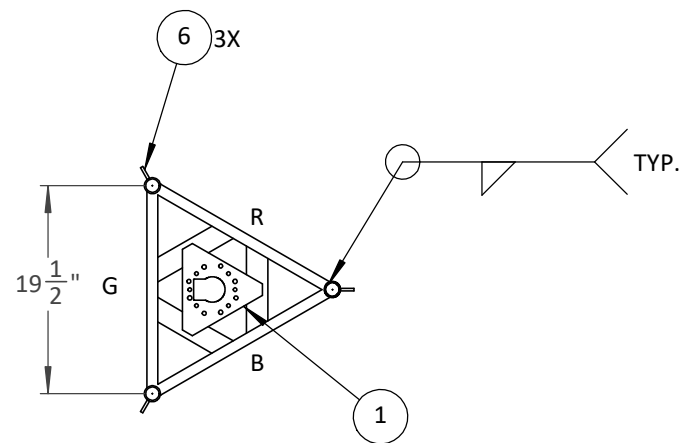

RED SIDE
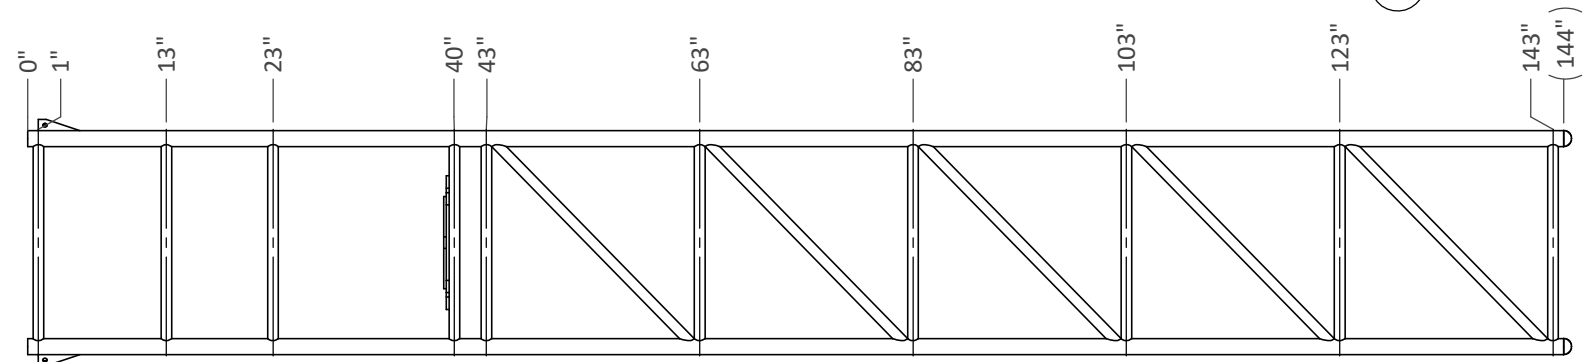
$$2X(4)$$


GREEN SIDE

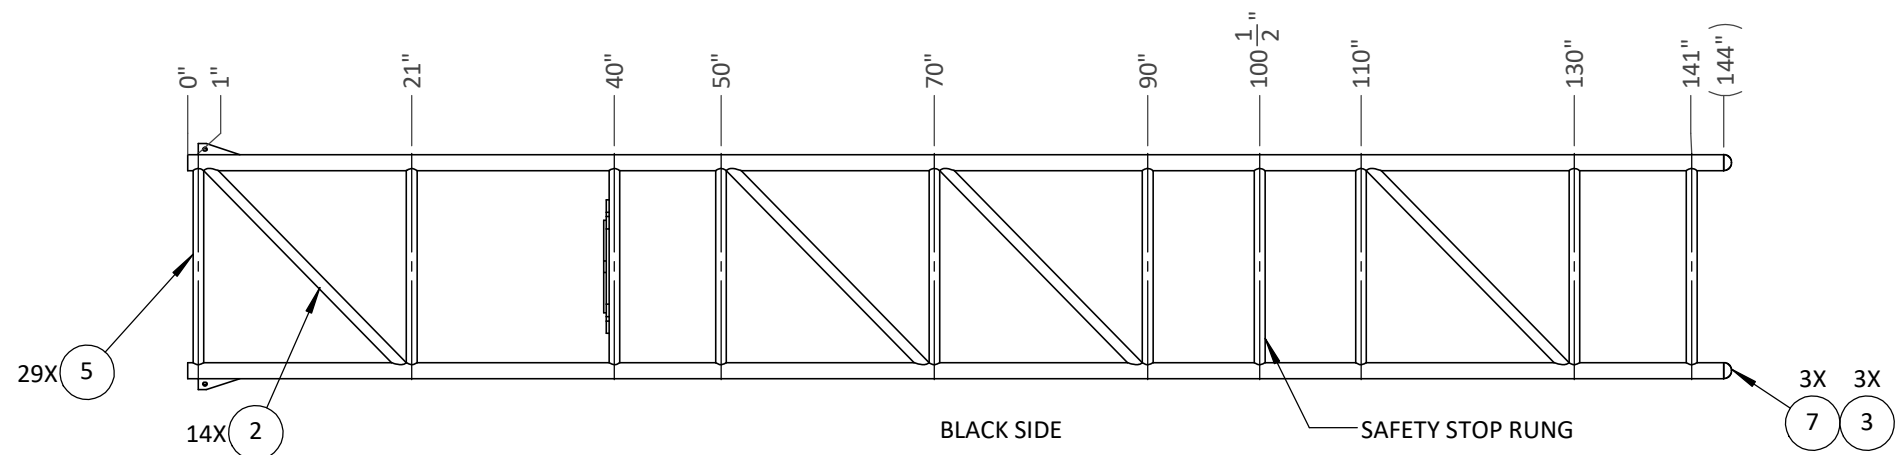

BLACK SIDE



— SAFETY STOP RUNG

ITEM NO.	QTY.	PART NUMBER	DESCRIPTION
1	1	701473	PLATE, MAST, COMBO ROTOR, D SECTION, BOTTOM
2	14	400303	DIAGONAL, D SECTION, 0.125" WALL
3	3	400122	LEG, 1.5" X 0.125" WALL X 12FT L, 6061-T6
4	2	400044	A FRAME, D SECTION, .125" WALL
5	29	400042	RUNG, D SECTION, .125" WALL
6	3	400001	BRACKET, GUYWIRE, TOWER
7	3	300005	CAP, HEMISPHERICAL, 1.50DX0.75HX0.132T IN


		UNLESS OTHERWISE SPECIFIED		NAME		DATE		 VERO BEACH, FLORIDA 32960 VOICE: 772.567.3423 FAX: 772.567.3432 ALUMATOWER.COM							
		DIMENSIONS ARE IN INCHES. DIMENSIONS WITH  SHALL BE INSPECTED. TOLERANCES: $\frac{x}{y} \pm \frac{1}{16}$ $\frac{\text{ANGLE}}{\text{MACH} \pm 1^\circ \text{ BEND} \pm 5^\circ}$ <u>DECIMAL</u> .X ±0.030 250   .XX ±0.010 .XXX ±0.005		DRAWN		JRR	12/14/22								
				CHECKED		JVJ	12/14/22								
				ENG APPR.											
				MFG APPR.											
				Q.A.											
				MATERIAL						TITLE: D SECTION, 12FT L, T-24XXHD					
USED ON		NEXT ASSY		REMOVE ALL BURRS AND BREAK EDGES R0.030 OR CHAMFER MAX		SEE BOM		SIZE B		DWG. NO. 703885		REV A			
PROPRIETARY AND CONFIDENTIAL THE INFORMATION CONTAINED IN THIS DRAWING IS THE SOLE PROPERTY OF ALUMA TOWER COMPANY INC.. ANY REPRODUCTION IN PART OR AS A WHOLE WITHOUT THE WRITTEN PERMISSION OF ALUMA TOWER COMPANY INC. IS PROHIBITED. VIOLATORS WILL BE PROSECUTED UNDER APPLICABLE STATE AND FEDERAL LAWS				· COMMERCIAL TOLERANCES APPLY TO STOCK SIZE · ALL DIMENSIONS APPLY AFTER SURFACE TREATMENT · PREPARE DRAWING BY ANSI Y14.5-2009 · DO NOT SCALE DRAWING				FINISH NONE		SCALE: 1:18		WT: 55.956 Lbs		SHEET 1 OF 1	

NOTES:
1. WELDING SHALL BE PER MIL-W-22248, CLASS 4.


REVISIONS				
REV.	DESCRIPTION	DATE	ENGINEER	ECN
A	RELEASED FOR PRODUCTION	12/14/22	JRR	N/A

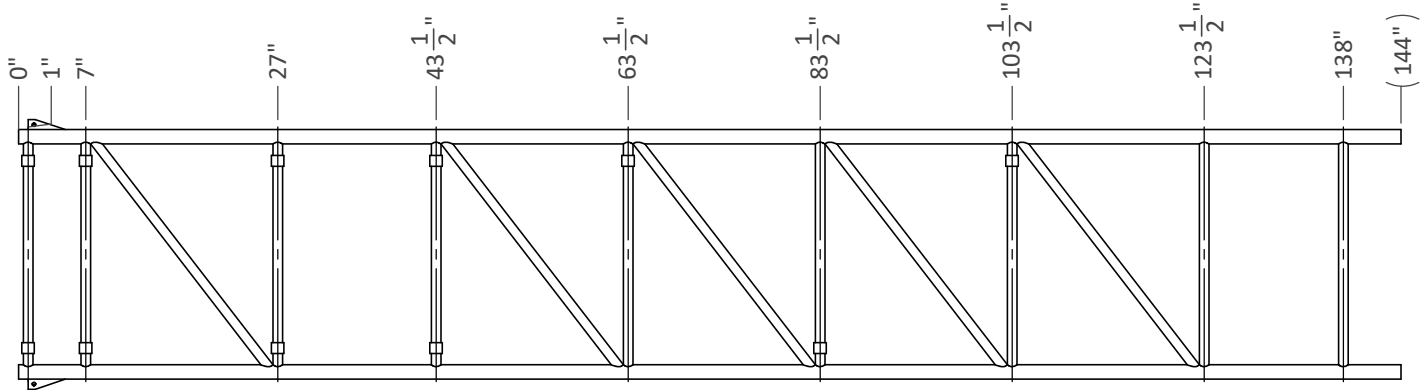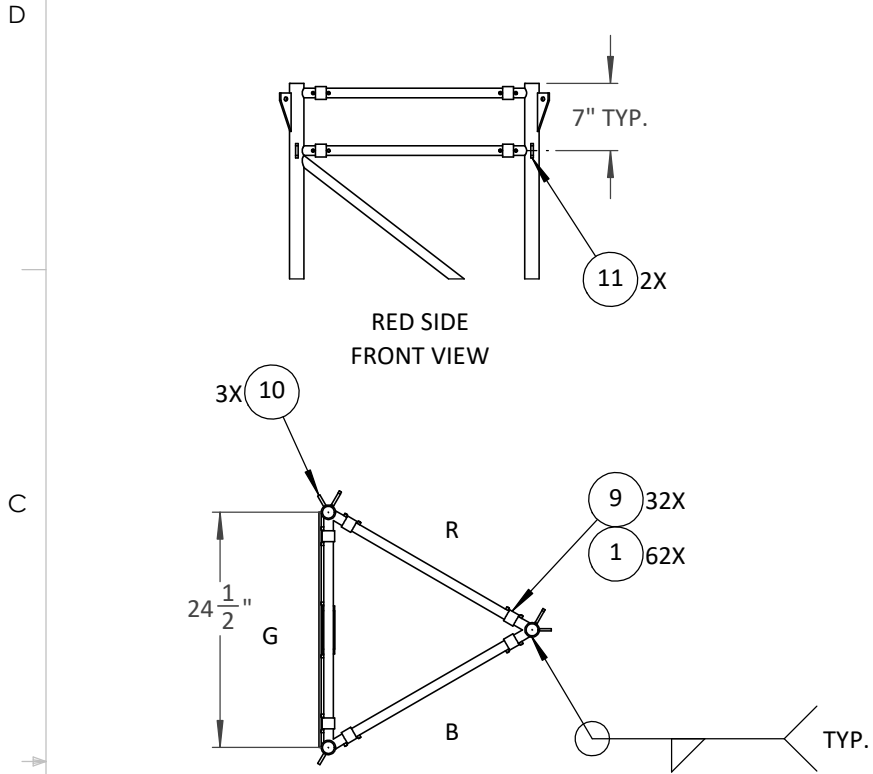

RED SIDE

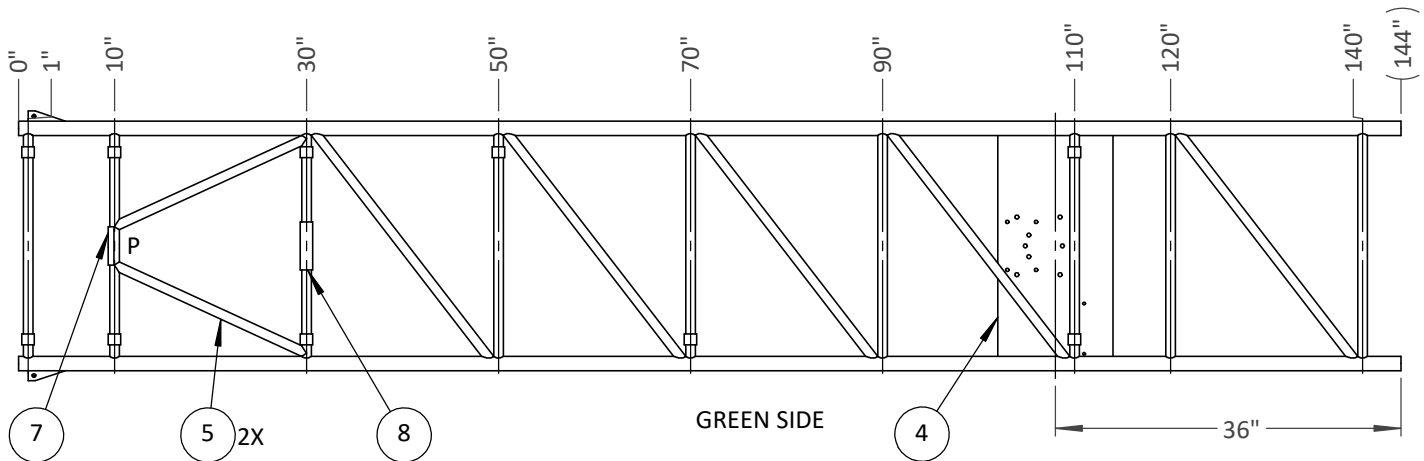

GREEN SIDE

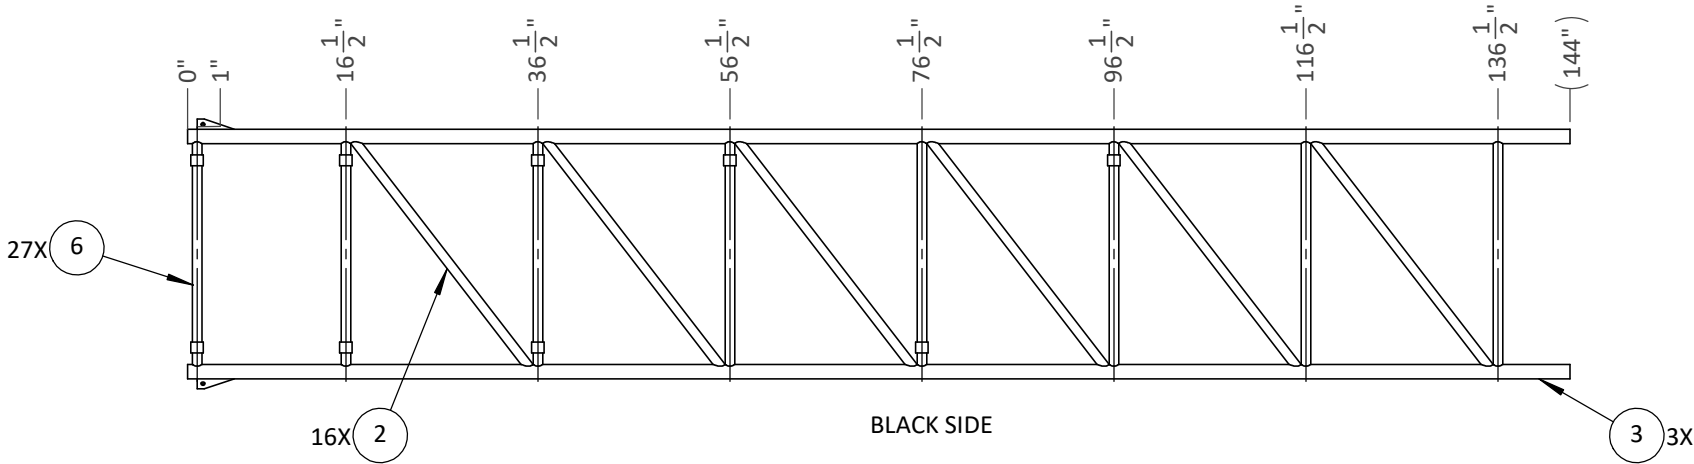





BLACK SIDE

ITEM	QTY.	PART NUMBER	DESCRIPTION
1	62	801266	ASSY, WASHER/RIVET, TOWER
2	16	400306	DIAGONAL, E SECTION, 1X.125" WALL
3	3	400122	LEG, 1.5" X 0.125" WALL X 12FT L, 6061-T6
4	1	400053	PLATE, WINCH, E SECTION
5	2	400040	A FRAME, E SECTION, .125" WALL
6	27	400038	RUNG, E SECTION, 1X.125"
7	1	400007	BRACKET, PULLEY SADDLE
8	1	400006	ROLLER, ALUMINUM, 5" LONG
9	32	400003	ROLLER, ALUMINUM, 1.125"L, 1" SCH 40 PIPE
10	3	400001	BRACKET, GUYWIRE, TOWER
11	2	300023	BRACKET, SAFETY STOP, 0.25IN

		UNLESS OTHERWISE SPECIFIED DIMENSIONS ARE IN INCHES. DIMENSIONS WITH  SHALL BE INSPECTED. TOLERANCES: $\frac{X}{X} \pm \frac{Y}{16}$ DECIMAL .X ±0.030 .XX ±0.010 .XXX ±0.005 ANGLE MACH ± 1° BEND ± 5°   	NAME		DATE	 VERO BEACH, FLORIDA 32960 VOICE: 772.567.3423 FAX: 772.567.3432 ALUMATOWER.COM TITLE: E SECTION, 12FT L, T-24XXHD
			DRAWN	JRR	12/14/22	
			CHECKED	JVJ	12/14/22	
			ENG APPR.			
			MFG APPR.			
		Q.A.				
		MATERIAL				
		SEE BOM				
		FINISH				
		NONE				
USED ON	NEXT ASSY	REMOVE ALL BURRS AND BREAK EDGES R0.030 OR CHAMFER MAX				
PROPRIETARY AND CONFIDENTIAL THE INFORMATION CONTAINED IN THIS DRAWING IS THE SOLE PROPERTY OF ALUMA TOWER COMPANY INC. ANY REPRODUCTION IN PART OR AS A WHOLE WITHOUT THE WRITTEN PERMISSION OF ALUMA TOWER COMPANY INC. IS PROHIBITED. VIOLATORS WILL BE PROSECUTED UNDER APPLICABLE STATE AND FEDERAL LAWS		· COMMERCIAL TOLERANCES APPLY TO STOCK SIZE · ALL DIMENSIONS APPLY AFTER SURFACE TREATMENT · INTERPRET DRAWING PER ANSI Y14.5-2009 · DO NOT SCALE DRAWING				
			SIZE B	DWG. NO. 703886		REV A
			SCALE: 1:20	WT: 70.429 Lbs	SHEET 1 OF 1	


- NOTES:
1. LOCATION EQUIPMENT APPROXIMATELY AS SHOWN AT ASSEMBLY.
 2. MATCH DRILL FOR APPROPRIATE HARDWARE AT ASSEMBLY AS REQUIRED.

REVISIONS				
REV.	DESCRIPTION	DATE	APPROVED	ECN
A	RELEASED FOR PRODUCTION	05/06/19	JRR	N/A

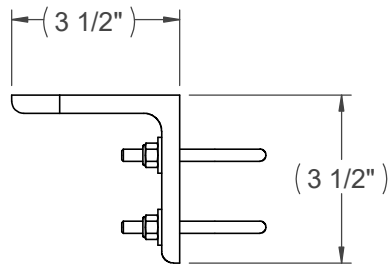
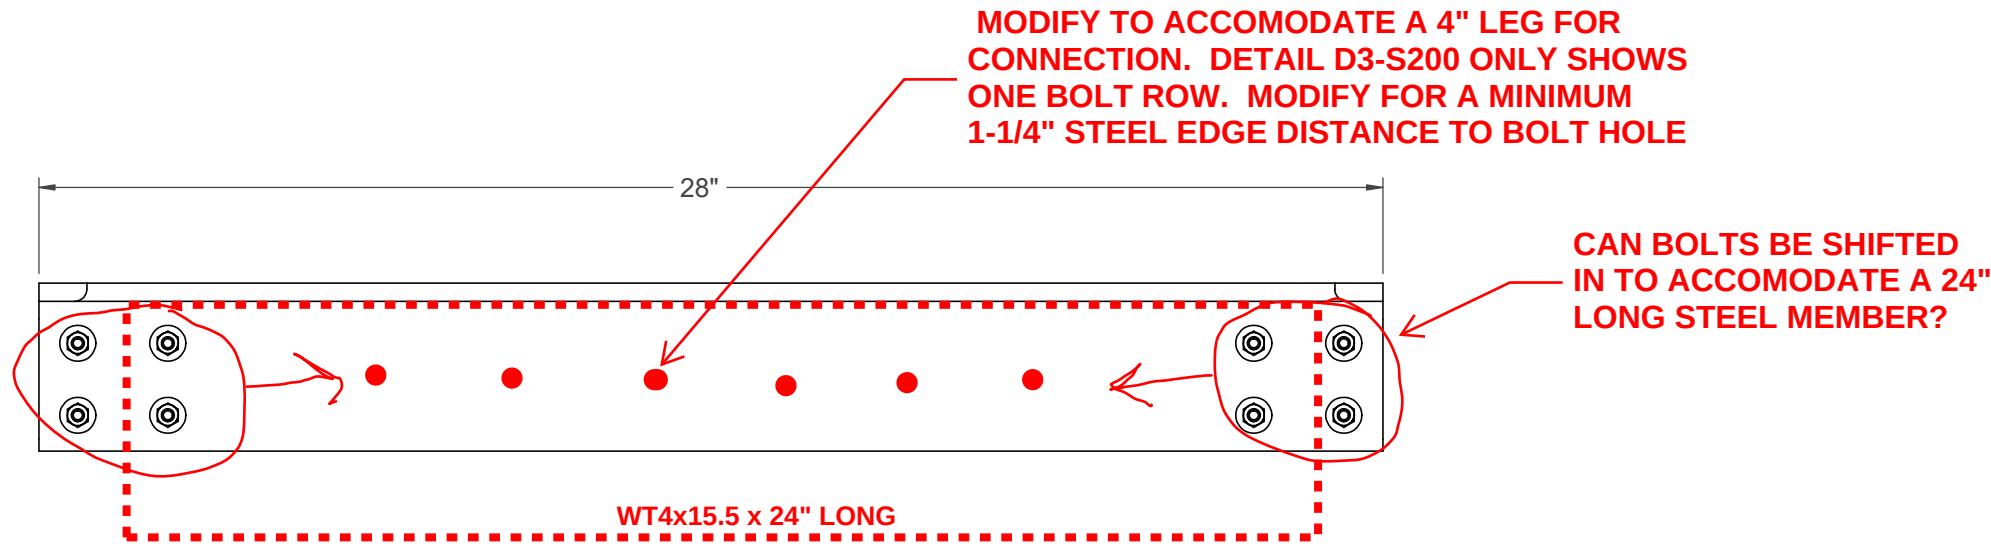
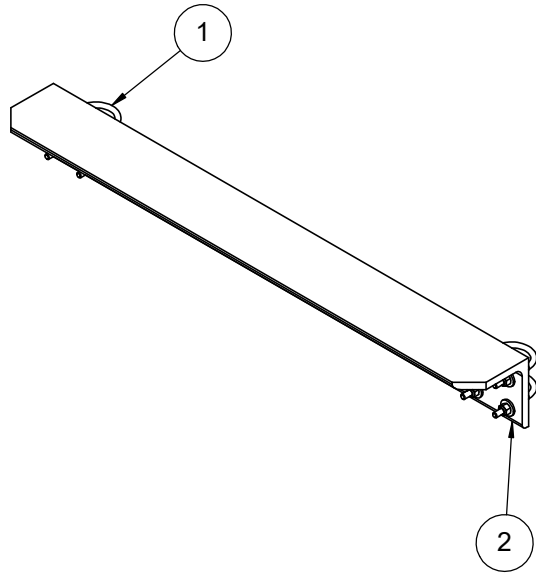
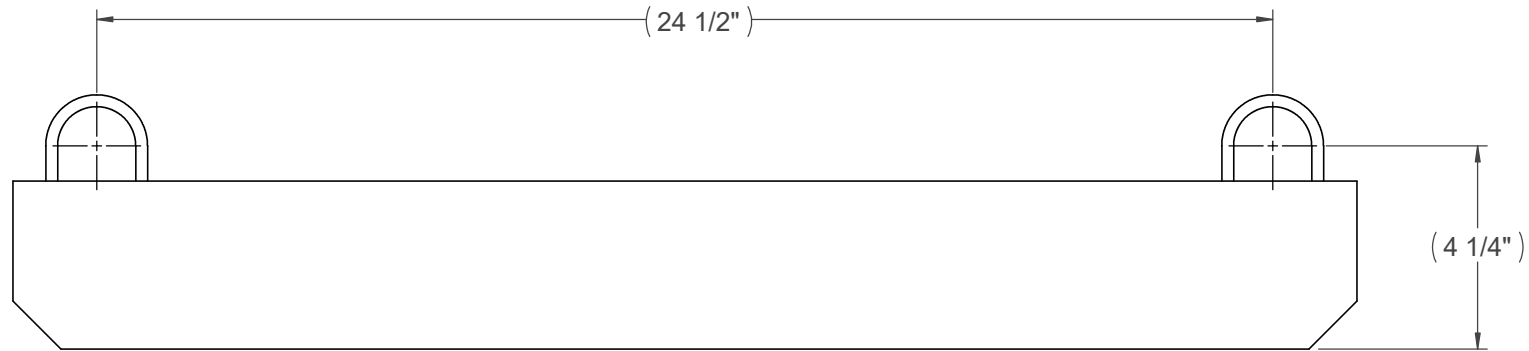


ITEM	QTY.	PART NUMBER	DESCRIPTION
1	4	801684	ASSY, U-BOLT, 1/4", FULL THREAD
2	1	401734	BRACKET, BUILDING MOUNT, E SEC, *CUSTOMER SPECIFIC

		UNLESS OTHERWISE SPECIFIED	NAME		DATE	 VERO BEACH, FLORIDA 32960 VOICE: 772.567.3423 FAX: 772.567.3432 ALUMATOWER.COM TITLE: BRACKET, BUILDING MOUNT, E SEC, *CUSTOMER SPECIFIC, ASSY		
			DRAWN	JRR	12/14/22			
			CHECKED	JVJ	12/14/22			
			ENG APPR.					
			MFG APPR.					
		DIMENSIONS ARE IN INCHES. DIMENSIONS WITH  SHALL BE INSPECTED. TOLERANCES: /X ± /16 ANGLE MACH ± 1° BEND ± 5° DECIMAL .X ±0.030 250  .XX ±0.010 .XXX ±0.005	Q.A.			SIZE B DWG. NO. 806177 REV A SCALE: 1:4 WT: 6.95 Lbs SHEET 1 OF 1		
			MATERIAL					
			SEE BOM					
			FINISH	NONE				
USED ON	NEXT ASSY	REMOVE ALL BURRS AND BREAK EDGES R0.030 OR CHAMFER MAX						
PROPRIETARY AND CONFIDENTIAL		· COMMERCIAL TOLERANCES APPLY TO STOCK SIZE · ALL DIMENSIONS APPLY AFTER SURFACE TREATMENT · INTERPRET DRAWING PER ANSI Y14.5-2009 · DO NOT SCALE DRAWING						
THE INFORMATION CONTAINED IN THIS DRAWING IS THE SOLE PROPERTY OF ALUMA TOWER COMPANY INC. ANY REPRODUCTION IN PART OR AS A WHOLE WITHOUT THE WRITTEN PERMISSION OF ALUMA TOWER COMPANY INC. IS PROHIBITED. VIOLATORS WILL BE PROSECUTED UNDER APPLICABLE STATE AND FEDERAL LAWS								

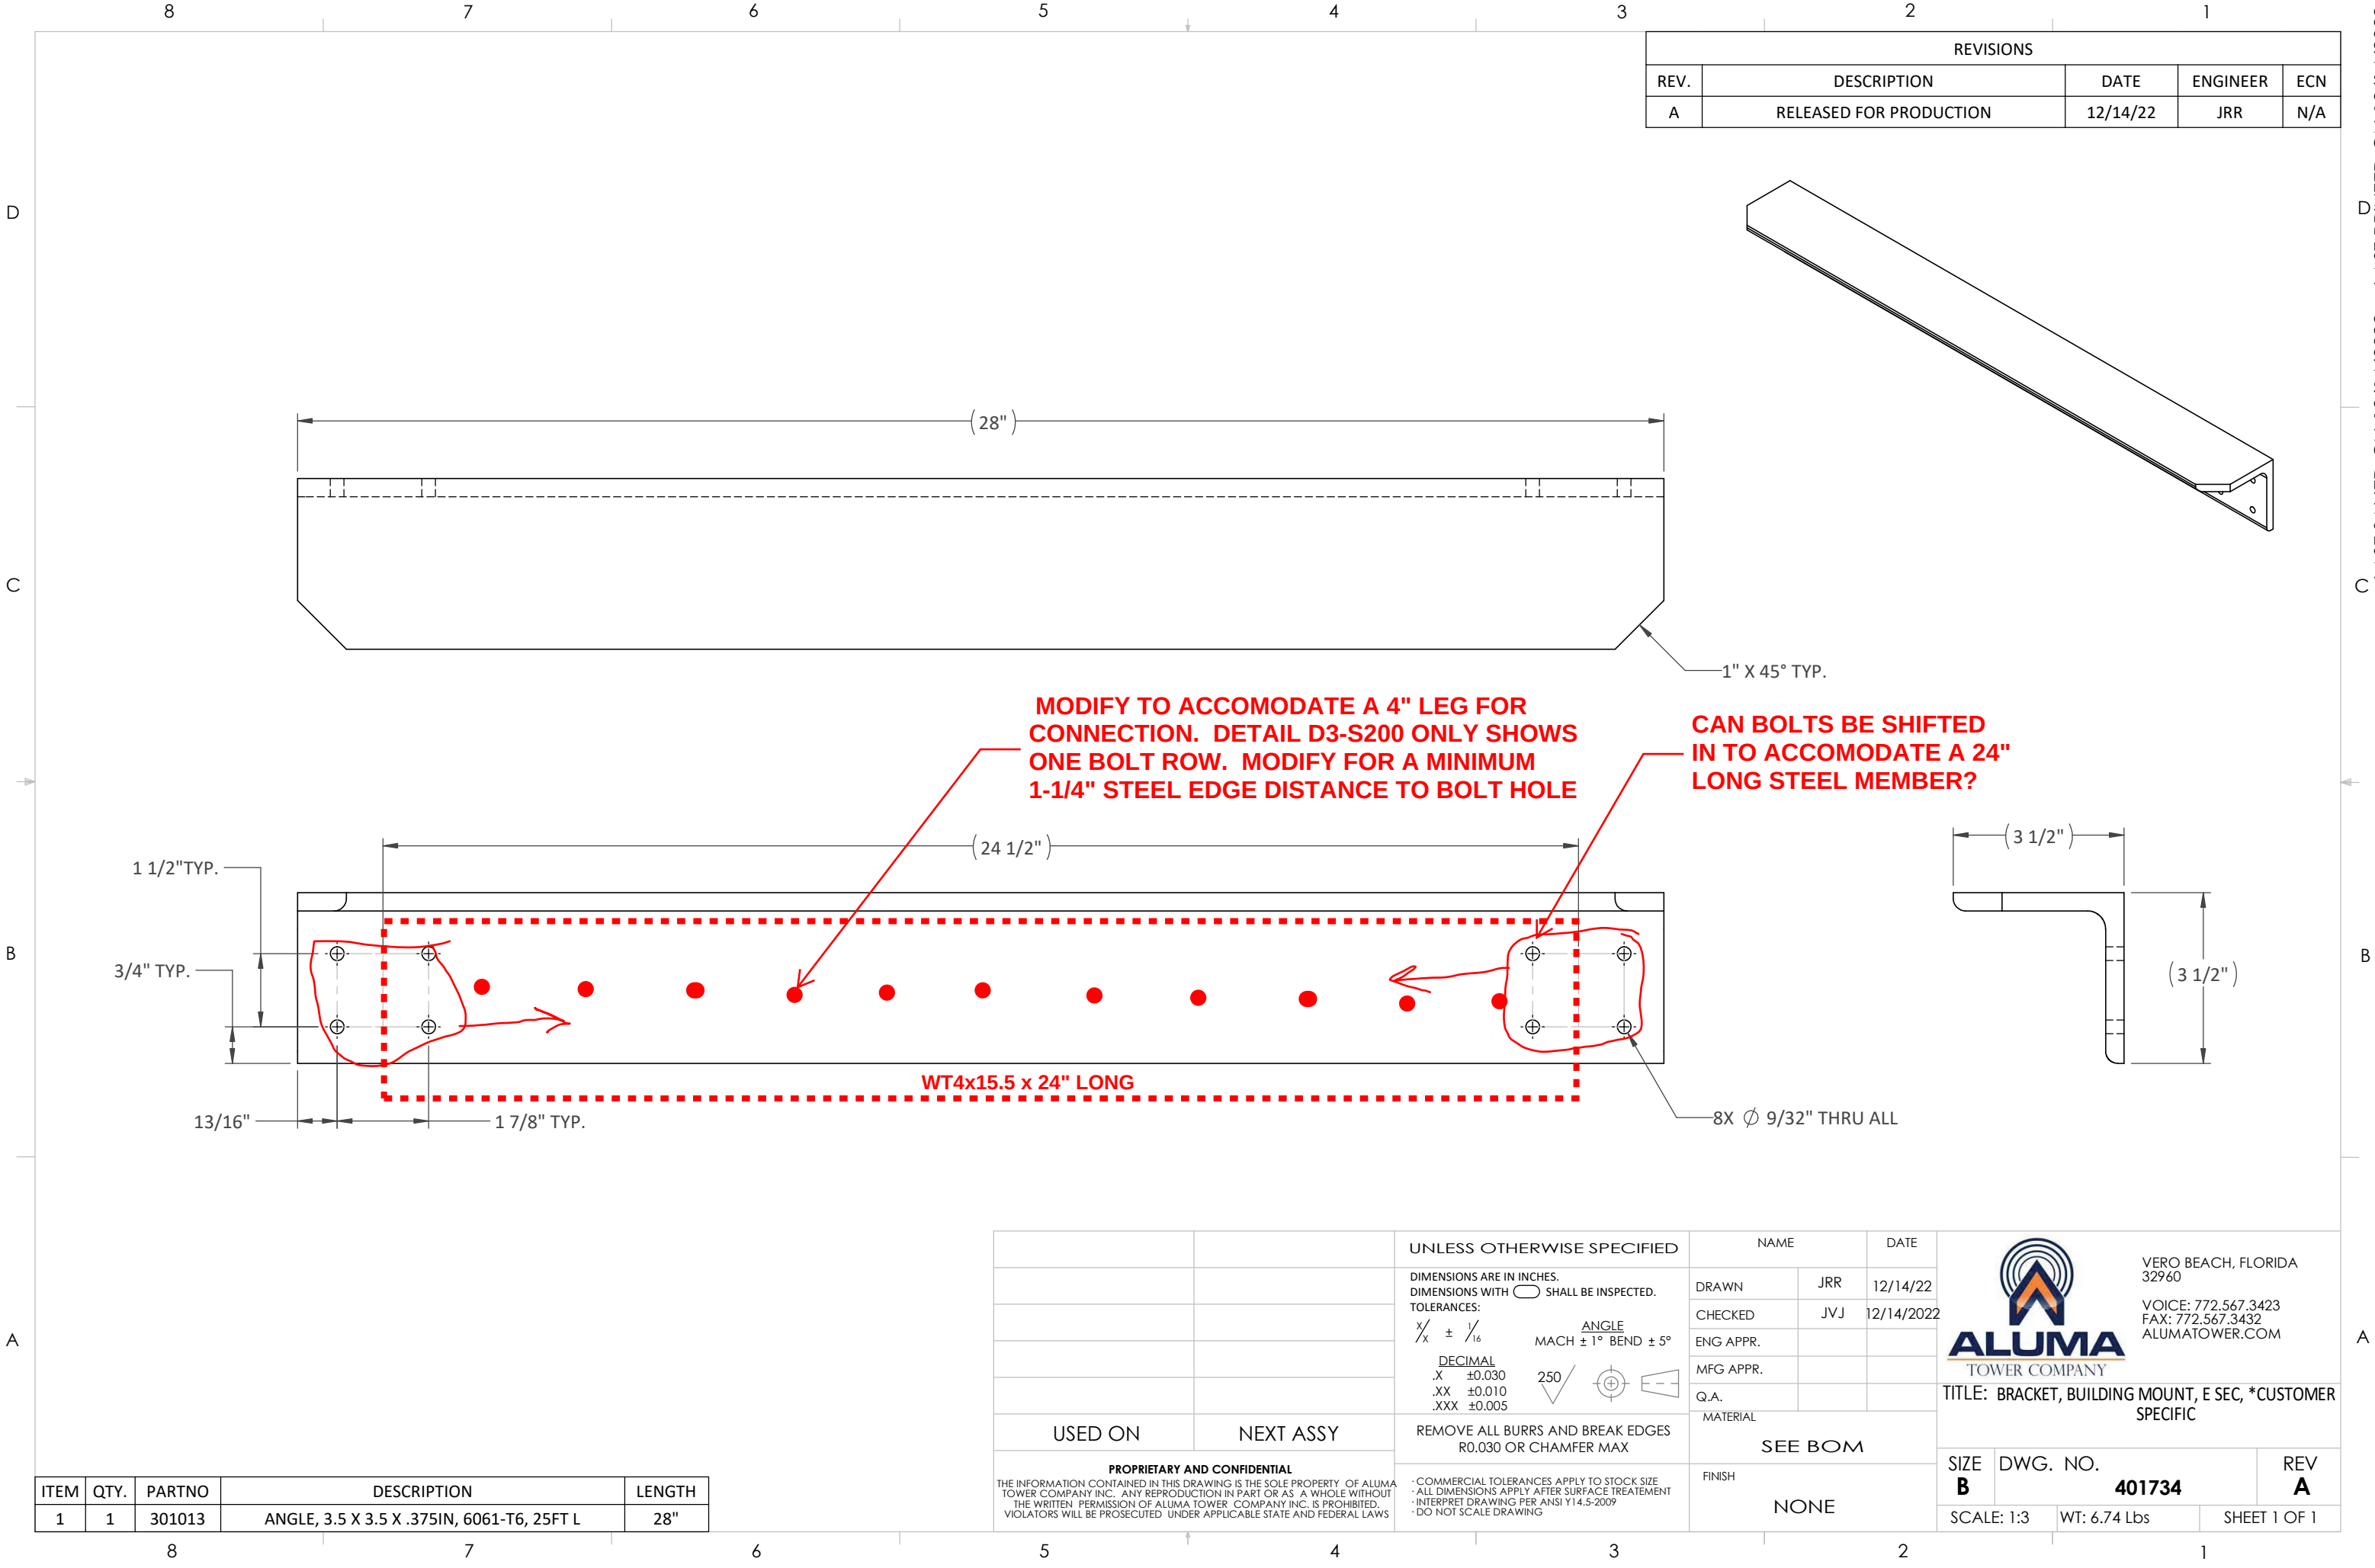

REVISIONS				
REV.	DESCRIPTION	DATE	ENGINEER	ECN
A	RELEASED FOR PRODUCTION	01/26/23	JRR	N/A

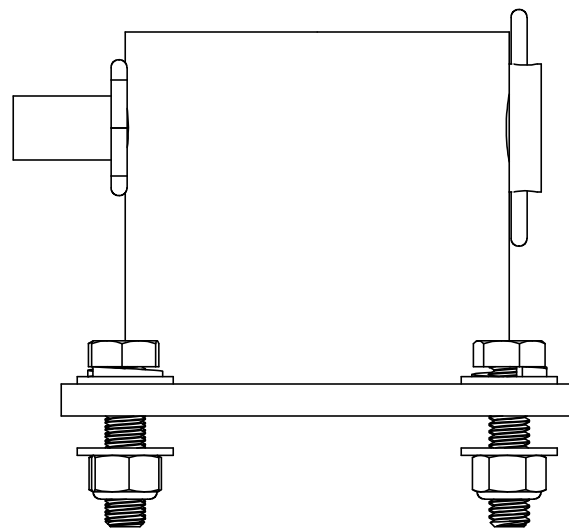
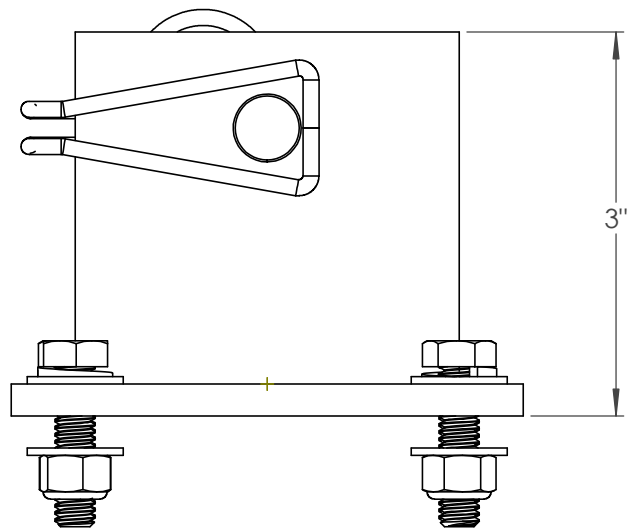
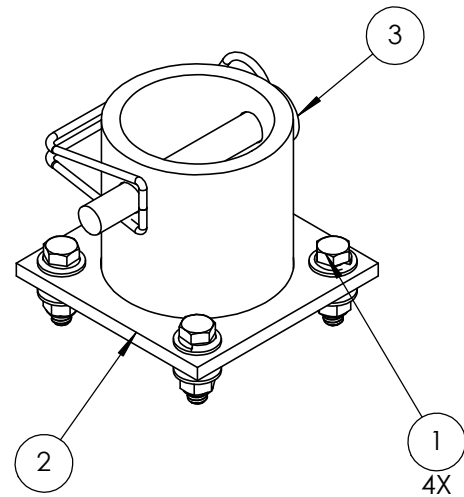
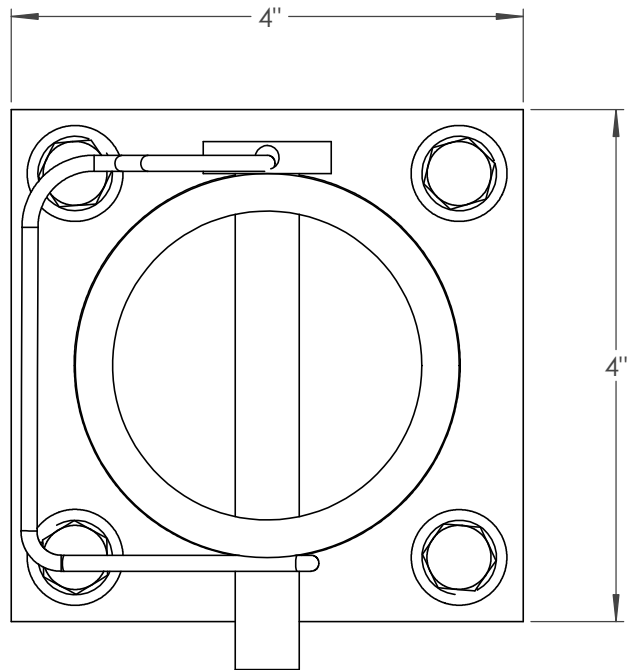


ITEM NO.	QTY.	PART NUMBER	DESCRIPTION
1	4	802275	BOLT,ASSY,5/16-18X1.25"L, HHCS
2	1	703896	ADAPTER, MAST, COMBO ROTOR PLATE, FOR 2.375" OD, WELD
3	1	100585	PIN, LOCKING, SQUARE WIRE, 1/2OD X 3L, SS

		UNLESS OTHERWISE SPECIFIED		NAME		DATE		 VERO BEACH, FLORIDA 32960 VOICE: 772.567.3423 FAX: 772.567.3432 ALUMATOWER.COM					
		DIMENSIONS ARE IN INCHES. DIMENSIONS WITH  SHALL BE INSPECTED. TOLERANCES: $\frac{x}{y} \pm \frac{z}{16}$ MACH $\pm 1^\circ$ BEND $\pm 5^\circ$ <u>DECIMAL</u> .X ± 0.030 250    .XX ± 0.010 .XXX ± 0.005		DRAWN		JRR	01/26/23						
				CHECKED		VS	01/26/23						
				ENG APPR.									
						MFG APPR.							
				Q.A.					TITLE: ADAPTER, MAST, COMBO ROTOR PLATE, FOR 2.375" OD, ASSY				
				MATERIAL									
USED ON		NEXT ASSY		REMOVE ALL BURRS AND BREAK EDGES R0.030 OR CHAMFER MAX		SEE BOM							
PROPRIETARY AND CONFIDENTIAL THE INFORMATION CONTAINED IN THIS DRAWING IS THE SOLE PROPERTY OF ALUMA TOWER COMPANY INC. ANY REPRODUCTION IN PART OR AS A WHOLE WITHOUT THE WRITTEN PERMISSION OF ALUMA TOWER COMPANY INC. IS PROHIBITED. VIOLATORS WILL BE PROSECUTED UNDER APPLICABLE STATE AND FEDERAL LAWS				· COMMERCIAL TOLERANCES APPLY TO STOCK SIZE · ALL DIMENSIONS APPLY AFTER SURFACE TREATMENT INTERPRET DRAWING TO CONFORM TO ANSI Y14.5-2009 · DO NOT SCALE DRAWING		FINISH NONE		SIZE B		DWG. NO. 804251		REV A	
								SCALE: 1:2		WT: 1.00 Lbs		SHEET 1 OF 1	

NOTES:
1. WELDING SHALL BE PER MIL-W-22248, CLASS 4.

REVISIONS				
REV.	DESCRIPTION	DATE	ENGINEER	ECN
A	RELEASED FOR PRODUCTION	01/26/23	JRR	N/A

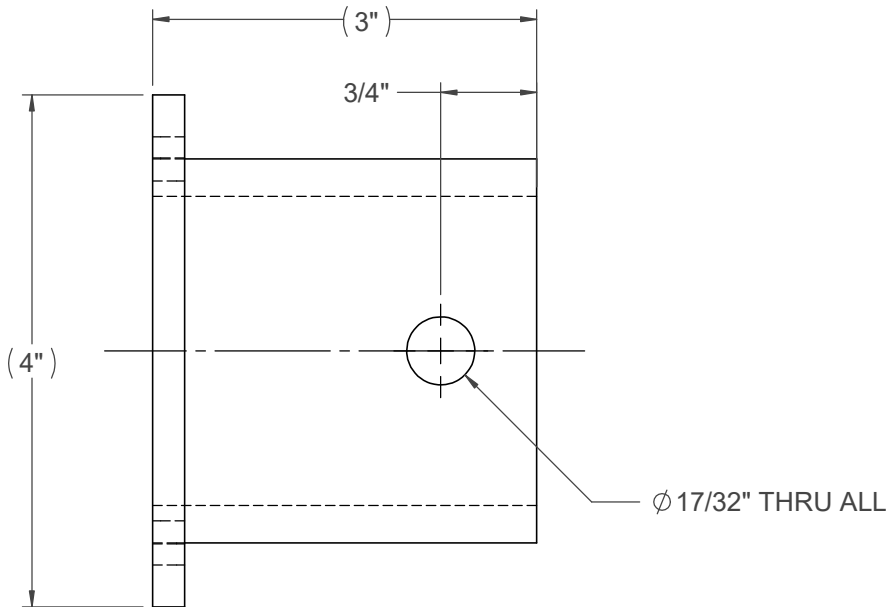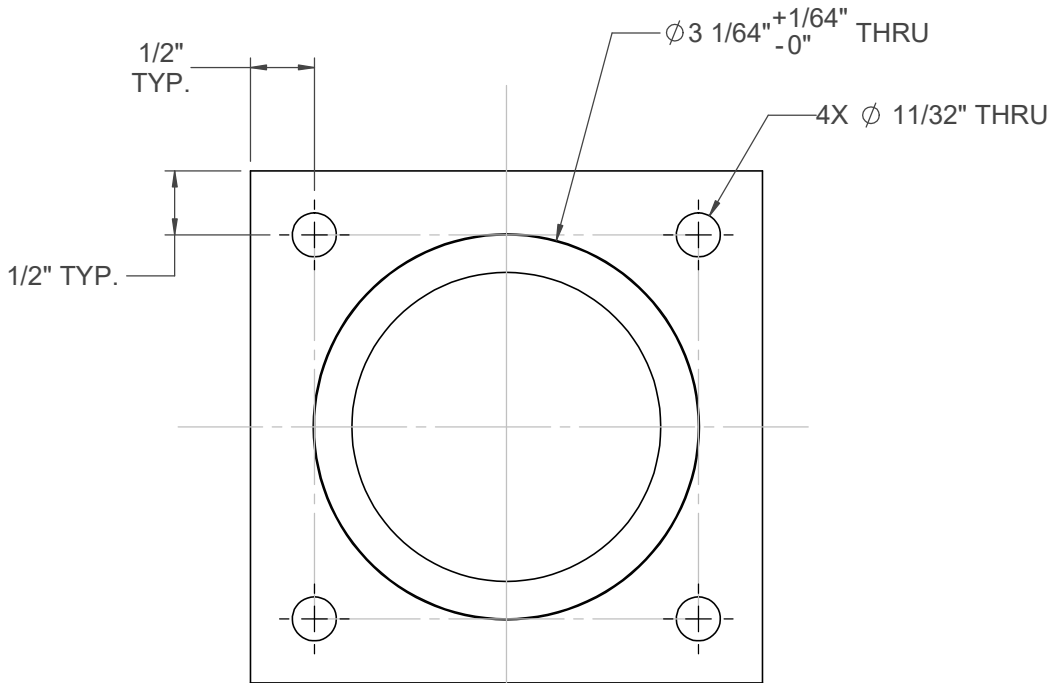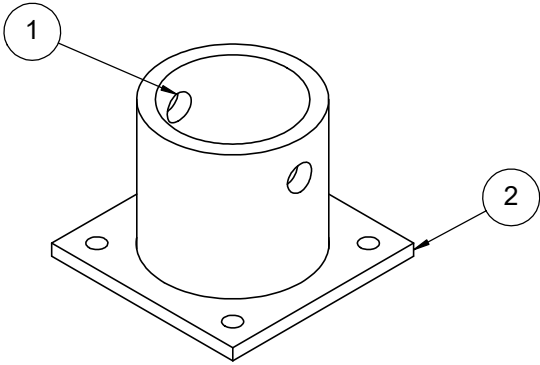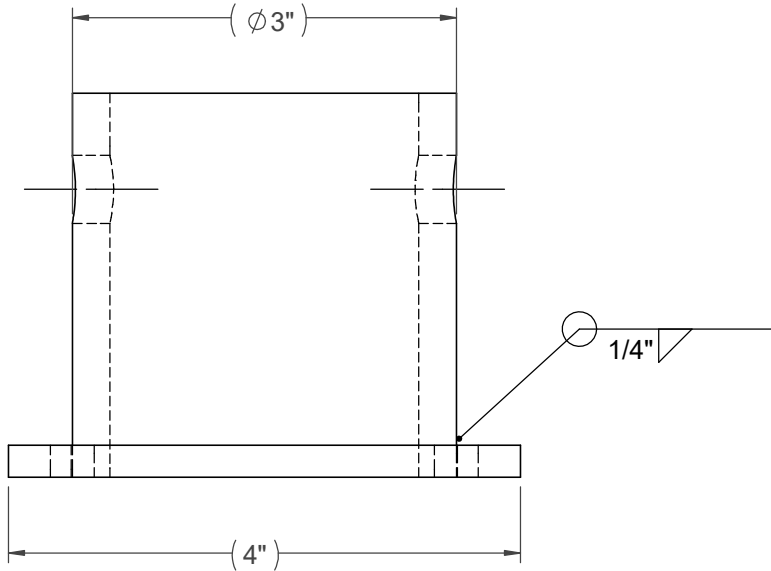

Weldment Cut List				
ITEM	QTY.	PARTNO	DESCRIPTION	LENGTH
1	1	301620	TUBE, ROUND, 3X0.293, 6061-T6, 20FT L	3"
2	1	301364	BAR, FLAT, 1/4X4"L, 6061-T6, 12FT L	4"

		UNLESS OTHERWISE SPECIFIED		NAME		DATE	 VERO BEACH, FLORIDA 32960 VOICE: 772.567.3423 FAX: 772.567.3432 ALUMATOWER.COM TITLE: ADAPTER, MAST, COMBO ROTOR PLATE, FOR 2.375" OD, WELD	
		DIMENSIONS ARE IN INCHES. DIMENSIONS WITH  SHALL BE INSPECTED.		DRAWN	JRR	01/26/23		
		TOLERANCES: /X ± /16		CHECKED	VS	01/26/23		
		DECIMAL .X ±0.030 .XX ±0.010 .XXX ±0.005		ENG APPR.				
		ANGLE MACH ± 1° BEND ± 5° 250		MFG APPR.				
USED ON		NEXT ASSY		Q.A.			SIZE B	
				MATERIAL				
				SEE CUT LIST			DWG. NO. 703896	
				FINISH NONE			REV A	
							SCALE: 1:2	
							WT: 0.92 Lbs	
							SHEET 1 OF 1	

PROPRIETARY AND CONFIDENTIAL
THE INFORMATION CONTAINED IN THIS DRAWING IS THE SOLE PROPERTY OF ALUMA TOWER COMPANY INC. ANY REPRODUCTION IN PART OR AS A WHOLE WITHOUT THE WRITTEN PERMISSION OF ALUMA TOWER COMPANY INC. IS PROHIBITED. VIOLATORS WILL BE PROSECUTED UNDER APPLICABLE STATE AND FEDERAL LAWS

· COMMERCIAL TOLERANCES APPLY TO STOCK SIZE
· ALL DIMENSIONS APPLY AFTER SURFACE TREATMENT
· INTERPRET DRAWING PER ANSI Y14.5-2009
· DO NOT SCALE DRAWING

